



DISTRICT PALWAL

LAYOUT PLAN OF UNAUTHORIZED COLONY, 289 QUANTAS IN THE REVENUE ESTATE OF VILLAGE - PALWAL, TEHSIL PALWAL, DISTRICT PALWAL, COMPREHENSIVE IN KARNATAKA NO. 158/20/3, 20/4, 21/1

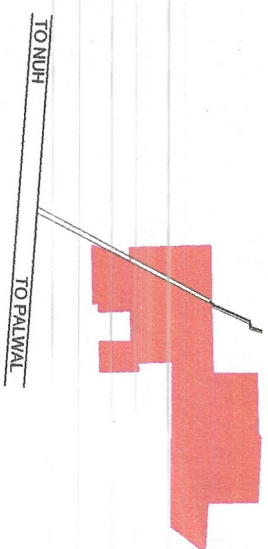

KEY PLAN

DETAILS OF UNAUTHORIZED COLONY			
Sr. No.	Parameter Name	Description	
1	Colony name	unrecorded_colony_2019	
2	Area	1.05 Acres (Category-A)	
3	Location of the colony	PALWAL	
(i)	Within MC	YES	
(ii)	Outside MC	NO	
4	Type of Colony and use (in %)	Residential Vacant 0.6 ACRES 0.5 ACRES	
5	Controlled Area	Controlled area found dated 01.04.1974	
6	Urban Area	Palwal	
7	Year of establishment	2017	
8	Layout Plan (Scale)	1:1000	
9	Total Pits	215	
10	Controlled Pits	61	
11	Number of vacant plots	154	
12	Number of families residing in the colony	61	
13	Does the colony have street light/electrification?	YES	
14	Does the colony have water supply through pipelines?	NO	
15	Does the colony have underground sewerage facility?	NO	
16	If connected to any external Sewage treatment plant? (Y/N)	No	
17	Does the colony have Park or Open space	No	
18	Road type on Colony (Kachha/pucca)	Maximum Road	
	Different roads (in meters)	Road Width	Length (in mtrs)
	Pucca Road		
	Kachcha Road	5.7 M	100.07 M
18	Minimum Road width	Minimum Road	
	Different roads (in meters)	Road Width	Length (in mtrs)
	Pucca Road		
	Kachcha Road	3.9 M	109.5
19	Total road length (in mtrs)	145.3 METERS	
20	Electricity provided to households through which sub station	66KV SUBSTATION PALWAL	
21	Is the RWA registered	No	
22	Additional information, if any		

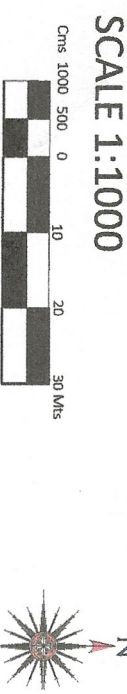

DRONE SURVEY AND LAYOUT PLAN PREPARED BY:-
PD CONSULTING ENGINEERS PVT.LTD

hello@pdcegroup.com www.pdcegroup.com
Red House, Behind MCD School,
Metrauli-Gurgaon Rd, Ghitorni, Delhi - 30

Checked: PDC Checked: Sdip Patel Sheet: A0
Drawn By: ISAM Sdip No.: 1 OF 1 Rev. No.: 00
NOTE:

ALL DIMENSIONS ARE IN METERS AND AREA IN ACRES.

DRG. NO. DTP/PAL/MC/13/2022 DATED

LAYOUT PLAN CHECKED AND VERIFIED AT SITE BY:-

JUNIOR DRAFTSMAN -

JUNIOR ENGG. -

PLANNING ASSTT:-

DISTRICT TOWN PLANNER -

OFFICE OF DISTRICT TOWN PLANNER, PALWAL
TOWN & COUNTRY PLANNING DEPTT., HARIYANA

Note:- As per Notification No. 25/11/87-35/Haryana dated 17 May 1993 Krishna No 158/17/2, 18/2, 19/2, 20/2, 1401/2,