DISTRICT MEWAT

LAYOUT PLAN OF MEWAT GREEN UDYOG & MEHER CHAND & OTHERS COLONY IN THE REVENUE ESTATE OF VILLAGE_TAORU TEHSIL TAORU DISTRICT MEWAT COMPRISING IN KHASRA NO.

103//3min,4min,7min,8min,Kanal- 12,13,14,15,16,17,19,22min,25,
104//14min,17min,23,24

KEY PLAN

UA NO_11922&11923

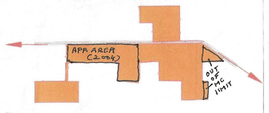

DETAILS OF UNAUTHORIZED COLONY

Sr. No.	Parameter Name	Description	
1	Colony name	Mewat Green Udyog & Meher Chand & Others	
2	Area	8.18 ACRES	
3	Location of the colony	Near Deogn Filling Station	
	(i) Within MC	YES	
	(ii) Outside MC	NO	
4	Type of Colony and use (in %)	Vacant	15.4 %
		Road	6.7 %
		Residential	78.3 %
5	Controlled Area	TOURU	
6	Urban Area	TOURU	
7	Year of establishment	2020	
8	Layout Plan (Scale)	1:1000	
9	Total Plots		
10	Constructed Plots	Sr 60_5#0+1#0=15 Sr 59_42#0+1#0=57	
11	Number of vacant plots		
12	Number of families residing in the colony	Sr 60-5 Sr 59-42	
13	Does the colony have street light?	No	
14	Does the colony have water supply through pipelines?	No	
	Does the colony have underground sewerage facility?	YES	
15	If connected to any external Sewage treatment plant? (Y/N)	No	
16	Does the colony have Park or Open space	No	
17	Road type on Colony (kacha/pucca)	Maximum Road	
18	Different roads (in meters)	Road Width	Length (in mtrs)
	Pacca Road	8M	123M
	Kachcha Road	6M	72.6M
19	Minimum Road width	Minimum Road	
20	Different roads (in meters)	Road Width	Length (in mtrs)
	Pacca Road	0M	0M
	Kachcha Road	3M	66.6M
	Total road Length (in mtrs)	977 M	
21	Electricity provided to households through which sub station	TAORU	
22	Area of the community site(in acres)	0.01 ACRES	
23	Is the RWA registered	No	
24	Additional Information, if any		

SCALE 1:1000

Cms 1000 500 0 10 20 30 Mts

N

DRONE SURVEY AND LAYOUT PLAN PREPARED BY: -
PD CONSULTING ENGINEERS PVT.LTD

PDCE GROUP
TRANSFORMING QUALITY & BUDGET

hello@pdcegroup.com www.pdcegroup.com
Red House, Behind MCD School,
Mehrauli-Gurgaon Rd, Ghitorni, Delhi - 30

Checked : PDCE	Surveyor : RISHI PAL	Sheet :- A0
Drawn By: NAYAB	Sht. No. :- 1 OF 1	Rev. No.:- R0

NOTE;
ALL DIMENSIONS ARE IN METERS AND AREA IN ACRES.

DRG. NO. DTP(MWT)-204/2022 DATED 11-3-22

LAYOUT PLAN CHECKED AND VERIFIED AT SITE BY: -

PATWARI

JUNIOR ENGG.

ASSITANT DRAFTSMAN ----------

JUNIOR DRAFTSMAN ----------

SENIOR DRAFTSMAN ----------

PLANNING ASSISTANT ----------

ASSISTANT TOWN PLANNER ----------

DISTRICT TOWN PLANNER

OFFICE OF DISTRICT TOWN PLANNER, MEWAT
TOWN & COUNTRY PLANNING DEPTT. ,HARYANA

25.03.2022
TW-3

-16-

(2)

→ Given Khasra No. needs to be re-checked.
- Provision of STP overall area Green belt not mentioned
IV-1 + 100mtr Green belt
- Boundary of the Colony not visible
- Revenue water be mark as per Ales - Site Plan
- Comment + 20m + Green belt

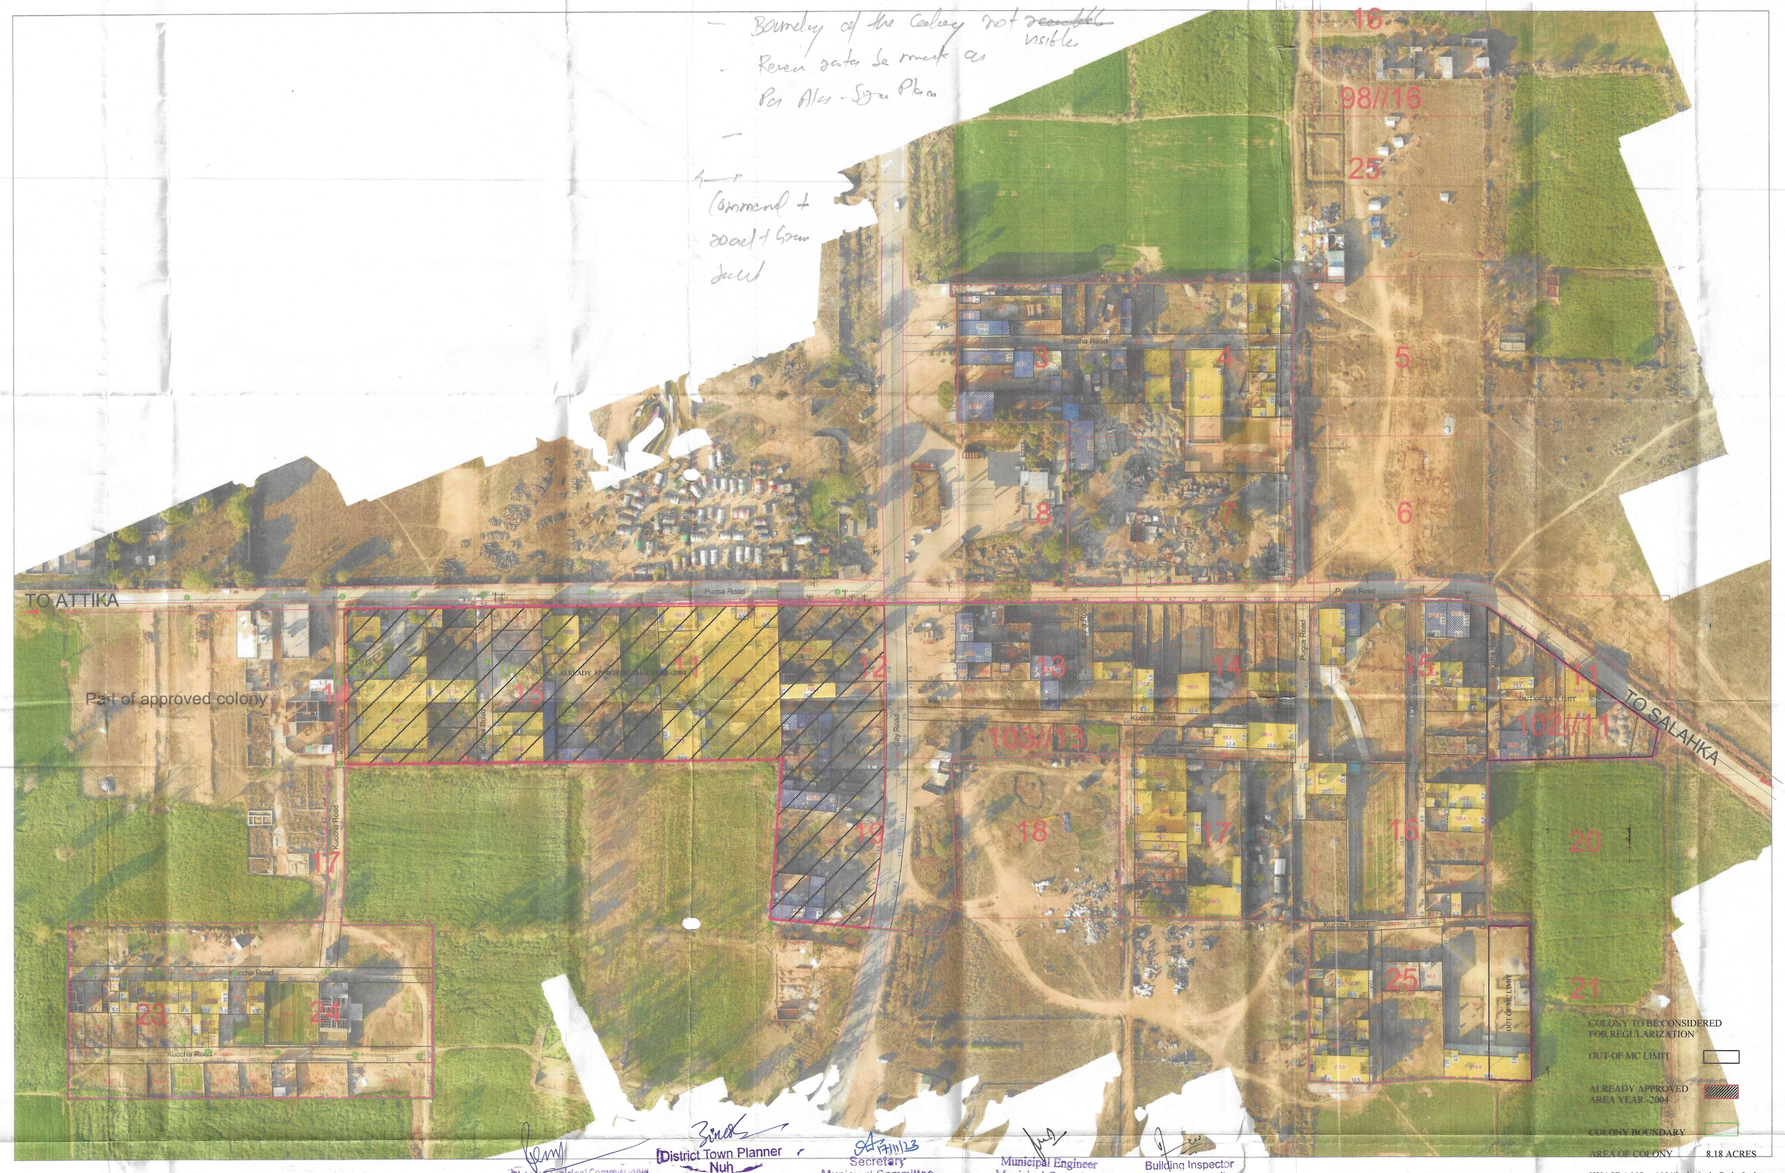

District Municipal Commissioner Nuh

District Town Planner Nuh

Secretary Municipal Committee Tauru (Nuh)

Municipal Engineer Municipal Committee Tauru (Mewat)

Building Inspector Municipal Committee Tauru (Mewat)

LEGEND

ManHole/ Chamber		Murraba Line		Commercial Area	C	Industrial Area	
TF/Electric/Mobile tower		Khasra Line		Built Up Area/Residential	R	Vacant Plot (Not to be Regularised)	Divider Road
Street Light/Solar pole		Colony Boundary		Vacant Land			Temple/Mosque/Church/Flag Post
Revenue Boundary		HT Line		Drain/Culvert / Bridge			Statue/School/Airport/Hospital/Well
City Road		Sewerage Line		Kuccha Road		Public & Semipublic Area	PB Tin Shed
		Water Supply Line		Pucca Road			