


DISTRICT NUH

LAYOUT PLAN OF VISHNU COLONY IN
THE REVENUE ESTATE OF VILLAGE, NUH, TEHSIL-NUH, DISTRICT-NUH
COMPRISING IN KHASRA NO. 50//13,14/2,14/3,17,18,23,24.

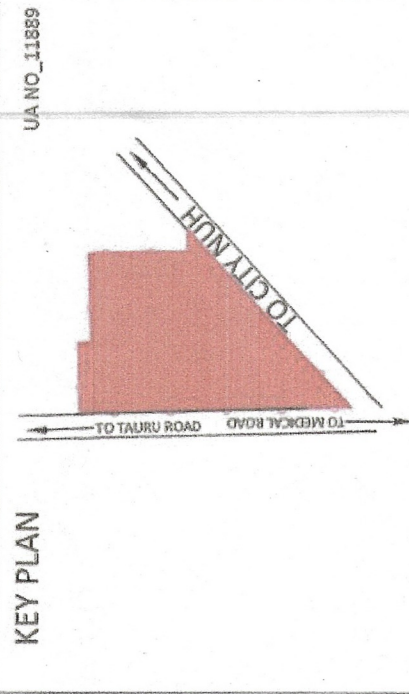

DETAILS OF UNAUTHORISED COLONY	
Sr. No.	Parameter Name
1	Colony name
2	Area
3	Location of the colony
4	Type of Colony and use (in %)
5	Constructed Area
6	Urban Area
7	Year of establishment
8	Layout Plan (Scale)
9	Total Plots
10	Constructed Plots
11	Number of vacant plots
12	Number of families residing in the colony
13	Does the colony have street light?
14	Does the colony have water supply through pipelines?
15	Does the colony have underground sewerage facility?
16	Does the colony have Park or Open treatment plant? (Y/N)
17	Road type of Colony (back/pucca)
18	Maximum Road Length (in meters)
19	Minimum Road Width (in meters)
20	Minimum Road Length (in meters)
21	Minimum Road Width (in meters)

SCALE 1:1000

DRONE SURVEY AND LAYOUT PLAN PREPARED BY :-
PD CONSULTING ENGINEERS PVT.LTD

hello@pdsgroup.com www.pdsgroup.com
Red House, Behind MCD School,
Mehrauli-Gurgaon Rd, Ghitorni, Delhi - 30

Checked : PDC	Surveyor : RISHI PAL	Sheet : A0
Drawn By : NAYAB	Stk. No. : 1 OF 1	Rev. No. : R0
NOTE: ALL DIMENSIONS ARE IN METERS AND AREA IN ACRES.		
DRG. NO. DTP(MN/T)Rep022, DATED 14-3-22.		
LAYOUT PLAN CHECKED AND VERIFIED AT SITE BY :-		
PATWARI / F.		
JUNIOR ENGS.		
ASSISTANT DRAFTSMAN		
JUNIOR DRAFTSMAN		
SENIOR DRAFTSMAN		
PLANNING ASSISTANT		
ASSISTANT TOWN PLANNER		
DISTRICT TOWN PLANNER		
OFFICE OF DISTRICT TOWN PLANNER		
TOWN & COUNTRY PLANNING DEPTT., HARYANA		



Municipal Engineer
Municipal Council Nuh

भवन निरीक्षक
नगर परिषद, नूह

कार्यकारी अधिकारी
नगर परिषद, नूह

District Town Planner
Nuh

District Municipal Commissioner
Nuh

COLONY TO BE CONSIDERED
FOR REGULARIZATION

COLONY BOUNDARY

AREA OF COLONY 5.0 ACRES

KHASRA NO. 50//13,14/2,14/3,17,18,
23,24

LEGEND	
ManHole/ Chamber	Murraba Line
TF/Electric/Mobile tower	Khasra Line
Street Light/Solar pole	Colony Boundary
Revenue Boundary	HT Line
City Road	Sewerage Line
	Water Supply Line
Commercial Area	Industrial Area
Built Up Area/Residential	Vacant Plot
Vacant Land	(Not to be Regularised)
Drain/Culvert / Bridge	Public & Semipublic Area
Kuccha Road	
Pucca Road	
	Divider Road
	Temple/Mosque/Church/Flag Post
	Statue/School/Airport/Hospital/Well
	Tin Shed